



# NATIONAL CERTIFIED TESTING LABORATORIES

FIVE LEIGH DRIVE • YORK, PENNSYLVANIA 17406 • TELEPHONE (717) 846-1200  
FAX (717) 767-4100  
www.nctlinc.com

## U-Factor, Solar Heat Gain Coefficient, Visible Transmittance and Condensation Resistance Calculation Report

**REPORT NO:** NCTL-110-18040-1  
**SIMULATION DATE:** 12/11/15  
**REPORT DATE:** 12/11/15

**Client:** ClimateGuard Manufacturing  
2500 North Manufacturing  
Chicago, IL 60639

**Product Line:** ClimateGuard Manufacturing's 1000 Vinyl Single Hung

**Specification:** ANSI/NFRC 100-2014: "Procedure for Determining Fenestration Product U-Factors".  
ANSI/NFRC 200-2014: "Procedure for Determining Fenestration Product Solar Heat Gain Coefficients and Visible Transmittance at Normal Incidence".  
NFRC 500-2014: "Procedure for Determining Fenestration Product Condensation Resistance Values".  
Therm 6.x / Window 6.x NFRC Simulation Manual (Approved at test date)  
Technical Interpretation Manual (2010)

**Procedures and Compliance:** All U-factor, Solar Heat Gain Coefficients, Visible Transmittance and Condensation Resistance values were calculated using the following characteristics: a default value of 0.30 solar absorptance for all products other than window glazed wall and sloped glazing which have a solar absorptance of 0.50. The best glazing option was used as the configuration for SHGC and VT specialty products table. NCTL is a NFRC accredited simulation laboratory and this simulation was conducted in full compliance with NFRC requirements. This report does not constitute an opinion or endorsement by the laboratory. Ratings values included in this report are for submittal to an NFRC-licensed IA and are not meant to be used directly for labeling purposes. Only those values identified on a valid Certification Authorization Report (CAR) by an NFRC accredited Inspection Agency (IA) are to be used for labeling purposes. Rounding per NFRC 601-2014: "NFRC Unit and Measurement Policy". The values included in this report are not considered in compliance with ANSI/NFRC 100, ANSI/NFRC 200, and/or NFRC 500 unless the associated validation test requirements have been satisfied, as applicable. Component values included in this report are for submittals to an NFRC-licensed IA and are not meant to be used directly for labeling purposes. Only those values approved and identified on a valid CMA Label Certificate are to be used for labeling purposes. The component(s) values included in this report are not considered in compliance with ANSI/NFRC 100 or ANSI/NFRC 200 unless the associated validation test requirements have been satisfied, as applicable.

**PRODUCT LINE DESCRIPTION**

**General:** The product line modeled is ClimateGuard Manufacturing's 1000 Vinyl Single Hung

Model Size Simulations: 1200 mm x 1500 mm (47.244" x 59.055")

**Weatherseals:**

Location	Weather Seal Description
Head	N/A
Lower Jamb	(3) Mohair
Meeting Rail	(2) Mohair
Sill	(3) Mohair & (1) Flexible Vinyl Bulb
Upper Jamb	N/A

**Gas Fillings:**

Gas Type	Filling Technique	Percentage
Argon	Double probe	95%

**Reinforcement:** Not applicable.

**Edge – of - Glass – Construction:** Exterior flexible vinyl leaf / silicone back bedding and Interior Vinyl Glazing Bead with (2) leafs of flexible vinyl

**Finish:** Vinyl

**Frame Description:**

Code	Type	Definition
VY	Vinyl	All members are vinyl with no reinforcements

**Sash Description:**

Code	Type	Definition
VY	Vinyl	All members are vinyl with no reinforcements

**Spacer and Sealant:**

Code	Type	Definition
CU-D	Coated Steel U-Shaped	Coated Steel (galvanized or tinplated) U-shaped spacer system embedded in sealant

**Dividers:** Where applicable, dividers were not modeled because the gap between dividers and lites were greater than 3mm. For Solar Heat Gain and Visual Light Transmittance default dividers less than 1" and greater or equal to 1" and default patterns were used for simulations.

**Divider Description:** 0.1875" x 0.6100" Painted Aluminum Rectangular

**Continuous Hardware Description:** Not applicable.

**Modeling Assumptions and Comments Deemed Important:****Sealing Rules:**

All cavities that are opened to the exterior within a frame section shall be modeled according to ISO 15099, Section 6.7.1, which states that cavities greater than 2mm but equal to or less than 10 mm shall be modeled as “slightly ventilated air cavities”. For physical testing purposes the product is sealed at the inside surface with tape or equivalent to prevent air infiltration. Air cavities created by this sealing technique must be simulated with the standard NFRC “Frame Cavity” material. If cavities on the frame are sealed (covered) to the surround panel with tape or equivalent, those cavities are also filled with NFRC “Frame Cavity” material within the simulation model. If the frame is not covered or sealed, those areas are left hollow or opened within the simulation model.

**Continuous elements:**

All elements continuous within the product line are identified from the Bill-of-Materials and detailed drawings via the referenced dimensions and cut lengths as compared to the overall size of the product.

**General Notes:**

The Condensation Resistance results obtained from this procedure are for controlled laboratory conditions and do not include the effects of air movement through the specimen, solar radiation, and the thermal bridging that may occur due to the specific design and construction of the fenestration system opening.

**Modeling assumptions:**

Per the client the nail flange is removable.

The product was modeled with a nominal 1” x 4” wood stud attached to the nail flange.

**Miscellaneous assumptions:**

1. The screen extrusions were not modeled.
2. All radii are simulated at angles.
3. The modeling was performed in accordance with the manufacturer's assembly drawing.

**Component Area and Frame Heights:**

Frame heights, calculated areas, area weighted values for U-factor, SHGC, and VT, and center –of-glazing are located in approved NFRC simulation programs for all individual products.

**NCTL Therm Section Filename Methodology**

<b>Filename Codes Example: HD-CU-D-F1_003.THM</b>	
HD	Frame Section (Head)
CU-D	Spacer (Intercept)
F1	Frame Description
_003	Glazing ID #3



PRODUCT	Product Number	Pane ID #1	Pane ID #2	Pane ID #3	Pane Thickness #1	Pane Thickness #2	Pane Thickness #3	Gap 1	Gap 2	Gap Fill 1	Gap Fill 2	% of Gap Fill 1	% of Gap Fill 2	Emissivity Surface 1	Emissivity Surface 2	Emissivity Surface 3	Emissivity Surface 4	Emissivity Surface 5	Emissivity Surface 6	Tint	Spacer	Grid Type	Grid Size	U-factor	Condensation Resistance	SHGC NO GRID	SHGC GRID<1"	SHGC GRID>=1"	VT NO GRID	VT GRID<1"	VT GRID >=1"
0.1875" x 0.6100" Rect. Grid	24	2 mm Clear	2 mm Clear	2 mm Clear	0.086	0.086	0.086	0.306	0.306	AIR	AIR										CL	CU-D	G	0.75	0.37	52		0.52		0.54	
0.1875" x 0.6100" Rect. Grid	25	2 mm Comfort Select 73	2 mm Clear	2 mm Clear	0.087	0.086	0.086	0.306	0.306	ARG	ARG	95	95	0.148							CL	CU-D	G	0.75	0.30	59		0.45		0.50	
0.1875" x 0.6100" Rect. Grid	26	2 mm LoE <sup>3</sup> 366	2 mm Clear	2 mm Clear	0.087	0.086	0.086	0.306	0.306	ARG	ARG	95	95	0.022							CL	CU-D	G	0.75	0.28	61		0.19		0.42	
0.1875" x 0.6100" Rect. Grid	27	2 mm LoE <sup>2</sup> 270	2 mm Clear	2 mm Clear	0.087	0.086	0.086	0.306	0.306	ARG	ARG	95	95	0.037							CL	CU-D	G	0.75	0.28	61		0.25		0.45	
0.1875" x 0.6100" Rect. Grid	28	2 mm LoE <sup>2</sup> 270	2 mm Clear	2 mm LoE <sup>2</sup> 270	0.087	0.086	0.087	0.306	0.306	ARG	ARG	95	95	0.037				0.037			CL	CU-D	G	0.75	0.23	64		0.23		0.39	
0.1875" x 0.6100" Rect. Grid	29	2 mm LoE <sup>2</sup> 272	2 mm Clear	2 mm Clear	0.087	0.086	0.086	0.306	0.306	ARG	ARG	95	95	0.042							CL	CU-D	G	0.75	0.28	61		0.28		0.47	
0.1875" x 0.6100" Rect. Grid	30	2 mm LoE <sup>2</sup> 272	2 mm Clear	2 mm LoE <sup>2</sup> 272	0.087	0.086	0.087	0.306	0.306	ARG	ARG	95	95	0.042				0.042			CL	CU-D	G	0.75	0.24	64		0.26		0.41	
VALIDATION	0	2 mm LoE <sup>2</sup> 270	2 mm Clear	2 mm LoE <sup>2</sup> 270	0.087	0.086	0.087	0.306	0.306	ARG	ARG	95	95	0.037				0.037			CL	CU-D	N		0.23	64	0.25		0.43		

A baseline product test in accordance with the "NFRC 102: Test Procedure for Measuring the Steady-State Thermal Transmittance of Fenestration Systems" is required in order to validate the "Model Size Matrix of U-Values" as previously indicated. Per Section 1.4.3 of ANSI/NFRC 100-2014, "the baseline product is the individual product selected for validation testing". **The individual product selected as the baseline product shall be the lowest simulated individual product or an individual product having a simulated U-factor within 0.60 W/ (m<sup>2</sup>\*K) (0.10 BTU/HR/ft<sup>2</sup>/°F) or 20% of the listed lowest simulated U-factor.**

**Note:**

1. For lowest U-factor listings where multiple individual products are shown, validation testing can be conducted on any within 20% of the lowest simulated u-factor.
2. Actual simulated individual products are required for product line validation testing.

-----> Res sizes

For the purposes of validation testing, production line units and sizes shall be used to represent the baseline product. Per the client, the model size is manufactured as part of their product line; therefore the previously listed model size can be used for baseline product validation testing.

-----> Deviation Sizes

For the purposes of validation testing, production line units and sizes shall be used to represent the baseline products. Representative sizes are therefore defined as the production sizes with the least deviation (D) from the model sizes, calculated per ANSI/NFRC 100. The previously listed model sizes shall be used for baseline product validation testing.

Copies of this report and the detailed product drawings will be retained by NCTL for a period of four (4) years. This report may not be reproduced, except in full, without the approval of NCTL. Results apply only to the fenestration product simulated. The attached diskette(s) contain(s) all required NFRC data and software files.

**NATIONAL CERTIFIED TESTING LABORATORIES**

Performed by:



**CHRISTOPHER PONDOLFINO**  
Simulator

Reviewed by:



DIGITAL SIGNATURE

**MARK BENNETT**  
NFRC Certified Simulator  
Simulator-In-Responsible-Charge

Attachments

**Report Log**

**Product Line:** ClimateGuard Manufacturing's 1000 Vinyl Single Hung

**Date:**  
**12/11/15** - Original Report issued to ClimateGuard Manufacturing and Inspection Agency

**ATTACHMENT A**

**Product Drawings**



TEST SPECIMEN COMPLIES  
 WITH THESE DETAILS.  
 ANY DEVIATION IS NOTED.  
 REPORT NO. NCTL-110-18040-1  
 TEST DATE 12/11/15

**BILL OF MATERIAL FOR 1000 SERIES SINGLE HUNG**

MIN SIZE: 15" X 32"


MAX SIZE: 50" X 78"

<u>COMPONENT</u>	<u>PART #</u>	<u>MANUFACTURER</u>
1. VINYL		VISION EXTRUSION
<del>2. BALANCES</del>	<del>ALUMA TILT 5/8"</del>	<del>CALDWELL MFG</del>
<del>3. BALANCE SHOE</del>	<del>16H70</del>	<del>-H-</del>
<del>4. PIVOT BAR</del>	<del>0045</del>	<del>TKG INC</del>
<del>5. LOCK &amp; KEEPER</del>	<del>677207 / 677120</del>	<del>DECO PRODUCTS</del>
<del>6. VENT LOCKS</del>	<del>110-2505-10</del>	<del>RO-MAI INDUST.</del>
7. TILT LATCH ASSY.	#WH106-2511-2L/2R	ASHLAND/TKG
<del>8. SETTING BLOCKS</del>	<del>1" X 7/8" X 1/8"</del>	<del>FRANK LOWE</del>
<del>9. ANCHOR FOR BALANCE SHOR</del>	<del>0237</del>	<del>TKG INC</del>
10. WEATHERSTRIP	W23251NG0010	AMESBURY/ULTRAFAB
11. SILLICONE	1199	DOW CORNING
<del>12. WEEP COVER</del>	<del>65605</del>	<del>ASHLAND PROD.</del>
<del>13. SCREWS:</del>		<del>MERCHANTS FASTENER</del>
<del>- FOR PIVOT BAR</del>	<del>#6X5/8 PH.FL.410 SS</del>	
<del>-FOR TILT LATCH</del>	<del>#8X1 PH.PAN.HD</del>	
<del>- FOR LOCK</del>	<del>#6X1 PH.FL.HD</del>	
<del>- FOR KEEPER</del>	<del>#6X1 1/4 PH.FL.HD</del>	
<del>- FOR BALANCES</del>	<del>#8X1 PH.FL.HD</del>	
<del>- FOR MULLION</del>	<del>#8X2 1/2 PH.PN.HD</del>	

**= NOT  
 MODELED IN  
 SIMULATION**

TEST SPECIMEN COMPLIES WITH THESE DETAILS.  
 ANY DEVIATION IS NOTED.  
 REPORT NO. NCTL-110-18040-1  
 TEST DATE 12/11/15

REVISIONS	
A2	Revised Tool reference number.

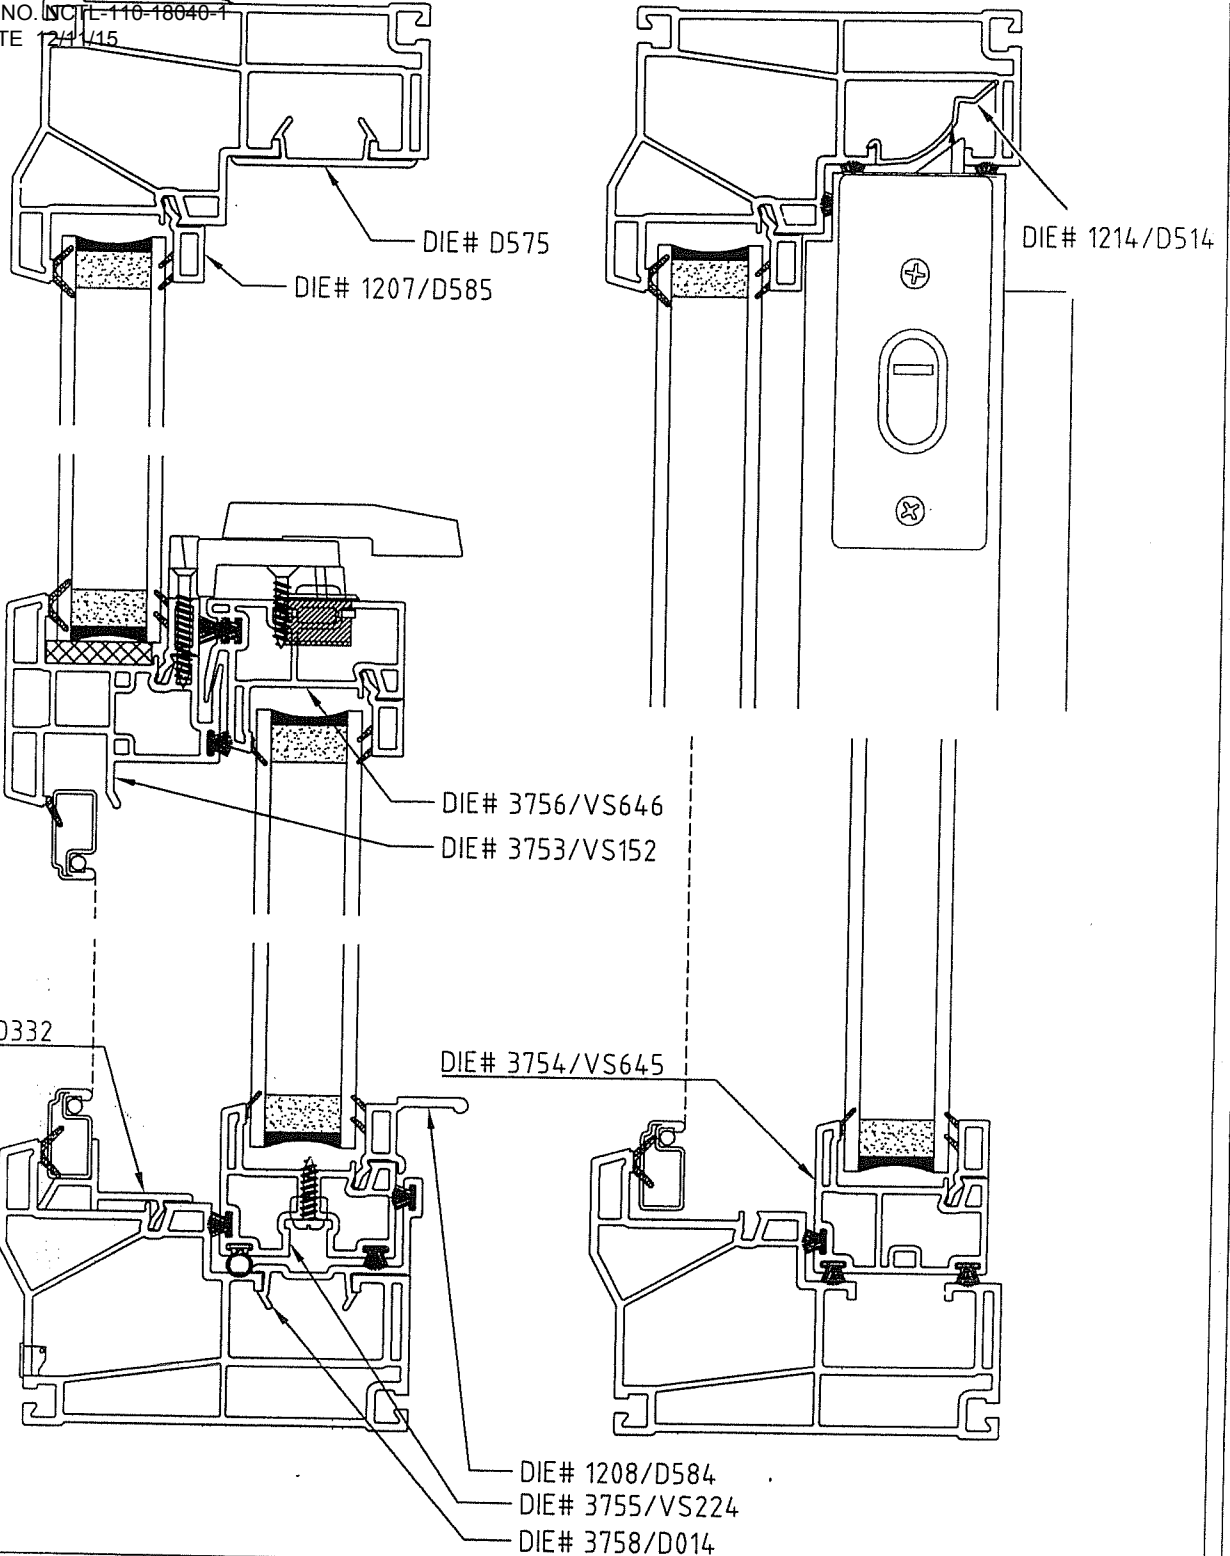


This document and the information contained is owned by and proprietary to Vision Extrusions Limited. By receipt hereof, the holder agrees not to use the information, disclose it to any third parties nor reproduce this document without the prior written consent of Vision Extrusions Limited, and agrees to return this document forthwith upon request.


TOLERANCES		CUSTOMER/DESCRIPTION:		
X.XX ± 0.015 X.XXX ± 0.010 X.XXXX ± 0.005 DO NOT SCALE DRAWING ALL DIMENSIONS ARE IN INCHES U.S.C.		CROSS-SECTION 1000 SINGLE HUNG		
SIZE: "A"	COLOUR: As specified			
SHEET: 1 of 1	DRAWN BY: MS	SCALE: n.f.s	PART NO.: N/A	DWG NO.: N/A

TEST SPECIMEN COMPLIES  
 WITH THESE DETAILS.  
 ANY DEVIATION IS NOTED.  
 REPORT NO. NCTL-110-18040-1  
 TEST DATE 12/11/15


REVISIONS	
A1	Current

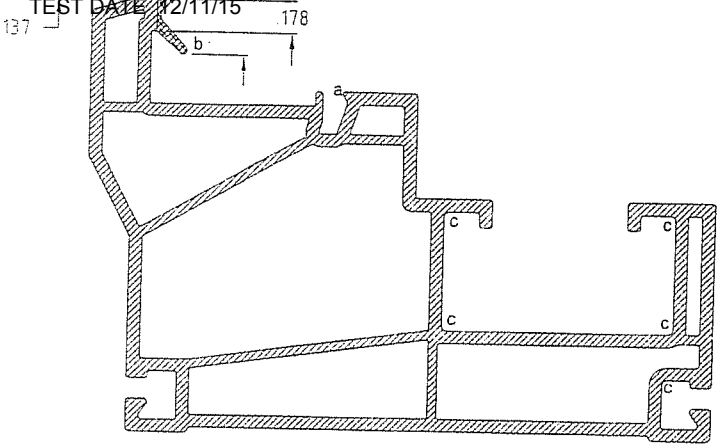

Radius & Flex Detail  
 Scale 1 : 1

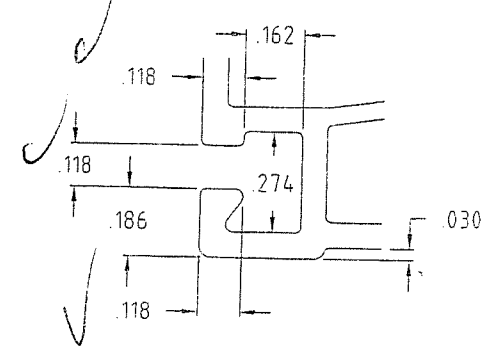

Detail A (Scale 2 : 1)  
 Typ. Interior & Exterior Accessory Groove  
 Unless otherwise Specified

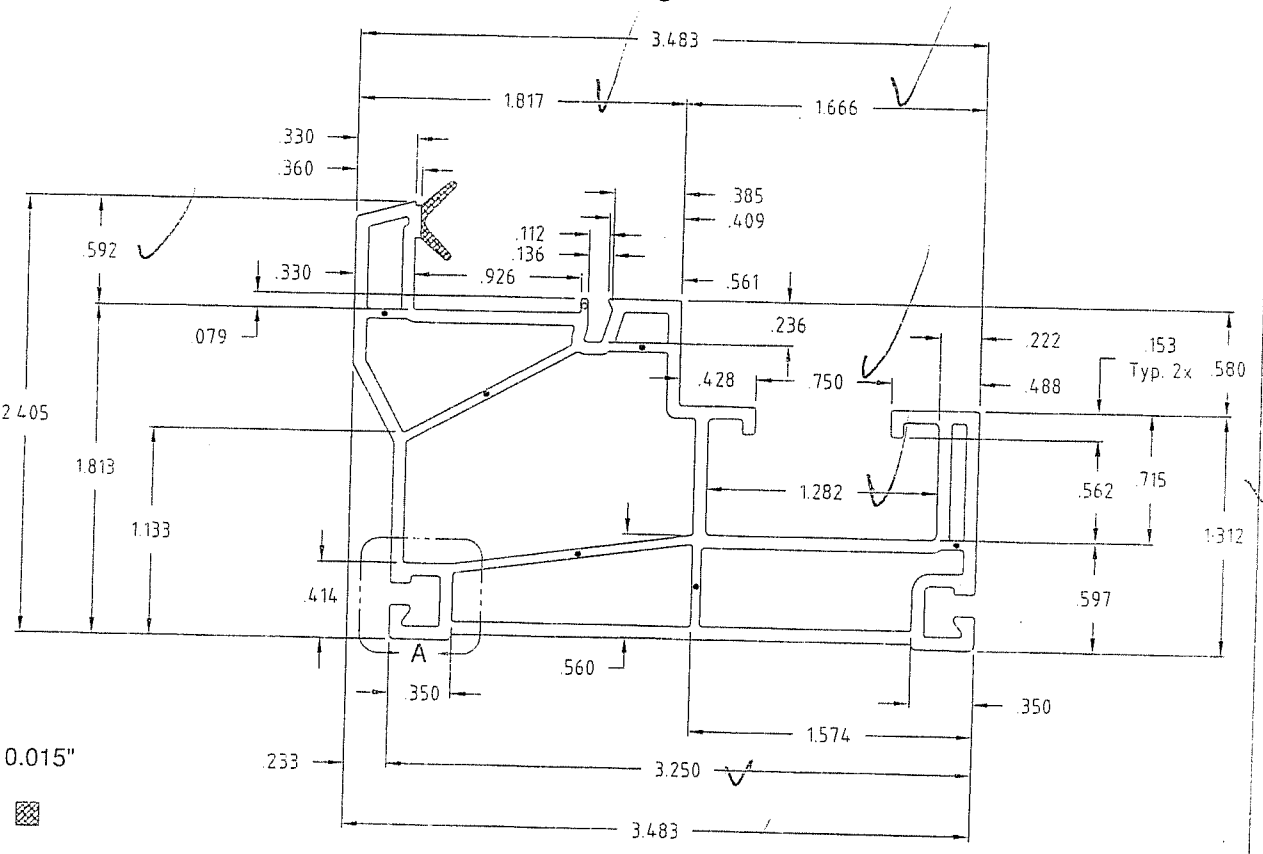

- RADII:**  
 a = 0.010"  
 b = 0.020"  
 c = 0.030"  
 d = 0.060"  
 e = 0.080"  
 f = full  
 s = Sharp  
 unmarked = 0.015"

FLEX AREA

WALL THICKNESS: UNLESS SPECIFIED

- NOMINAL = 0.070" ✓  
 • = 0.050" ✓  
 ◦ = 0.040"


This document and the information contained is owned by and proprietary to Vision Extrusions Limited. By receipt hereof, the holder agrees not to use the information, disclose it to any third parties nor reproduce this document without the prior written consent of Vision Extrusions Limited, and agrees to return this document forthwith upon request.




<b>TOLERANCES</b> X.XX ± 0.015 X.XXX ± 0.010 X.XXXX ± 0.005 DO NOT SCALE DRAWING ALL DIMENSIONS ARE IN INCHES U.S.S.		CUSTOMER/DESCRIPTION: <b>202 Series - Single Hung Main Frame          Part Drawing</b>		
SIZE: "A"	COLOUR: As specified	MATERIAL: As specified	TOOL NO.: 3752	DATE: 03/15/2012
SHEET: 1 of 1	DRAWN BY: RJO	SCALE: 1 : 1	PART NO.: V-155	DWG NO.: E202F04

TEST SPECIMEN COMPLIES WITH THESE DETAILS. ANY DEVIATIONS NOTED. REPORT NO. MCTL-110-18040-1 TEST DATE: 12/11/15

REVISIONS	
A1	Current

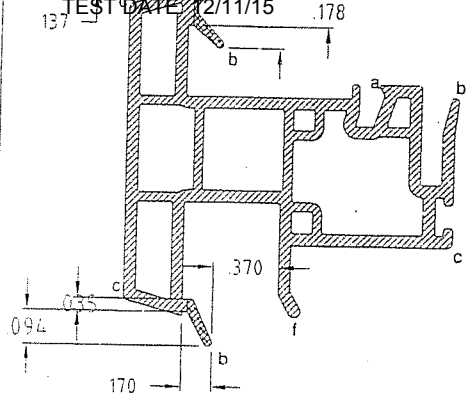

Radius & Flex Detail Scale 1:1

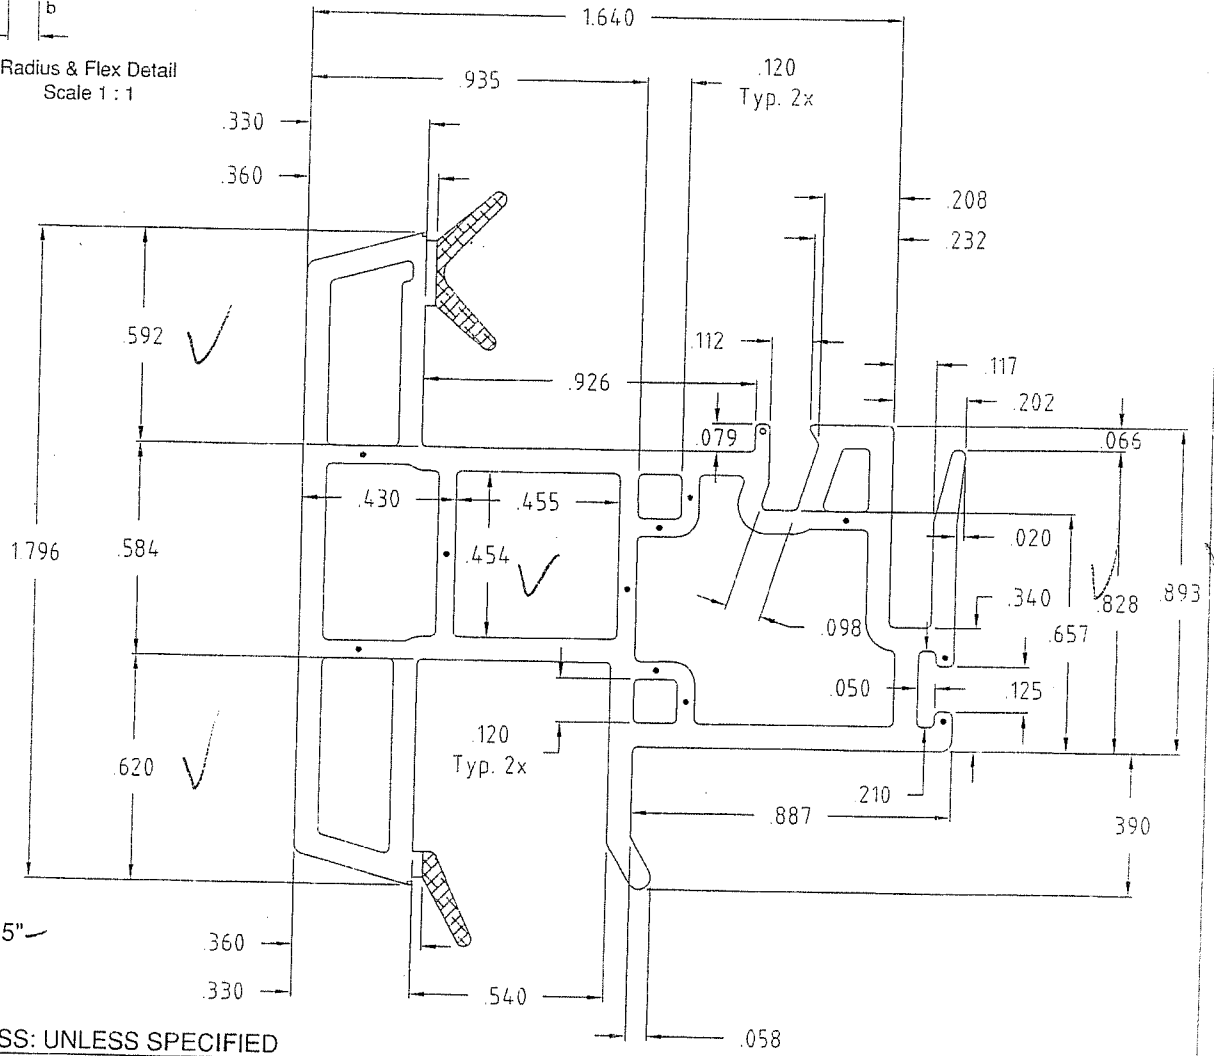

- RADII:**  
a = 0.010"  
b = 0.020"  
c = 0.030"  
d = 0.060"  
e = 0.080"  
f = full  
s = Sharp  
unmarked = 0.015"

**FLEX AREA**

**WALL THICKNESS: UNLESS SPECIFIED**  
NOMINAL = 0.065"  
• = 0.050"  
◦ = 0.040"


This document and the information contained is owned by and proprietary to Vision Extrusions Limited. By receipt hereof, the holder agrees not to use the information, disclose it to any third parties nor reproduce this document without the prior written consent of Vision Extrusions Limited, and agrees to return this document forthwith upon request.




<b>TOLERANCES</b> X.XX ± 0.015 X.XXX ± 0.010 X.XXXX ± 0.005 DO NOT SCALE DRAWING ALL DIMENSIONS ARE IN INCHES U.S.O.2		<b>CUSTOMER/DESCRIPTION:</b> 202 Series - Single Hung Mullion Part Drawing		
SIZE: "A"	COLOUR: As specified	MATERIAL: As specified	TOOL NO.: 3753	DATE: 03/15/2012
SHEET: 1 of 1	DRAWN BY: RJO	SCALE: 1 : 1	PART NO.: V-152	DWG NO.: E202F05

TEST SPECIMEN COMPLIES  
 WITH THESE DETAILS.  
 ANY DEVIATION IS NOTED.  
 REPORT NO. NCTL-110-18040-1  
 TEST DATE 12/11/15

REVISIONS	
A1	Current

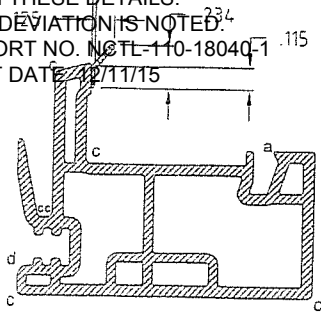

Radius & Flex Detail  
 Scale 1 : 1

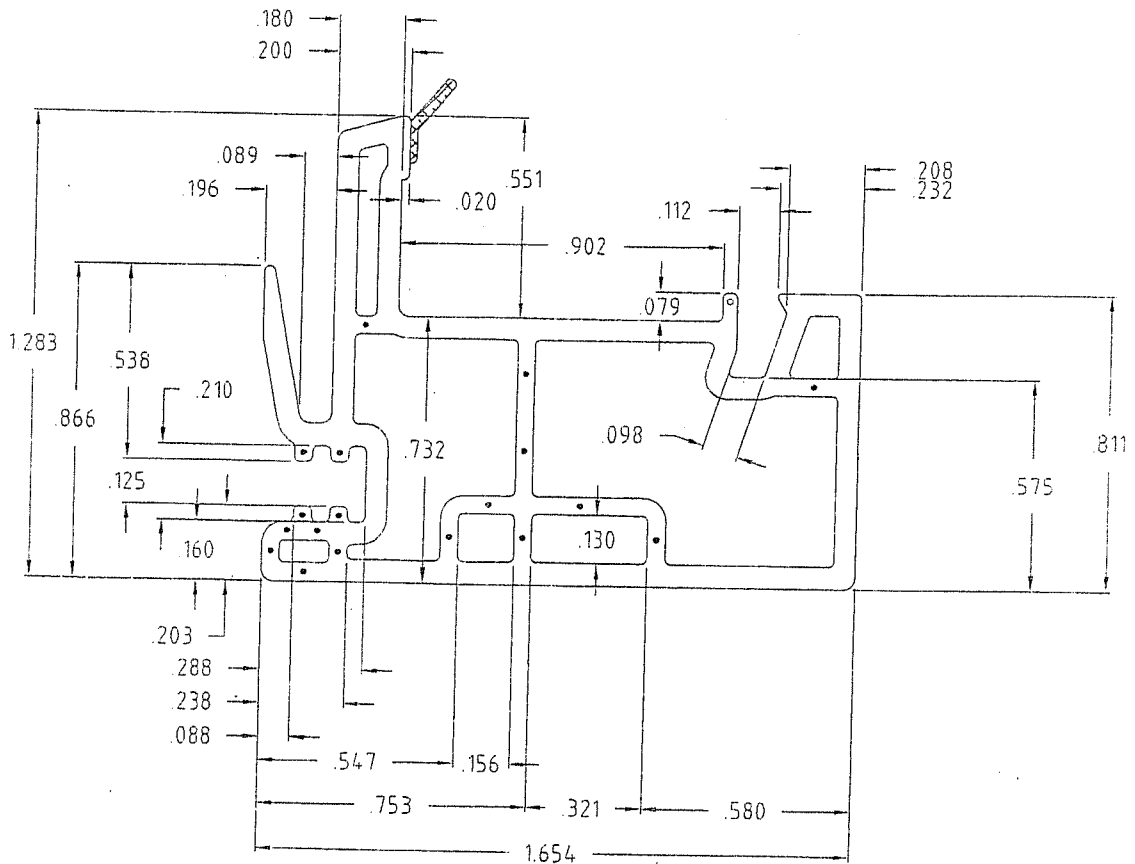

**RADII:**

- a = 0.010"
- b = 0.020"
- c = 0.030"
- d = 0.060"
- e = 0.080"
- f = full
- s = Sharp
- unmarked = 0.015"

FLEX AREA

**WALL THICKNESS: UNLESS SPECIFIED**


- NOMINAL = 0.060"
- = 0.050"
- = 0.040"



This document and the information contained is owned by and proprietary to Vision Extrusions Limited. By receipt hereof, the holder agrees not to use the information, disclose it to any third parties nor reproduce this document without the prior written consent of Vision Extrusions Limited, and agrees to return this document forthwith upon request.

TOLERANCES		CUSTOMER/DESCRIPTION:		
X.XX ± 0.015 X.XXX ± 0.010 X.XXXX ± 0.005 DO NOT SCALE DRAWING ALL DIMENSIONS ARE IN INCHES U.S.S.		202 Series - Interlock Sash Part Drawing		
SIZE:	COLOUR:	MATERIAL:	TOOL NO.:	DATE:
"A"	As specified	As specified	3756	03/19/2012
SHEET:	DRAWN BY:	SCALE:	PART NO.:	DWC NO.:
1 of 1	RJO	2 : 1	V-646	E202S03

TEST SPECIMEN COMPLIES WITH THESE DETAILS. ANY DEVIATION IS NOTED. REPORT NO. NCTL-110-18640-1 TEST DATE 12/11/15

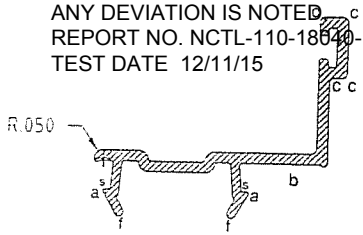


Radius Detail  
Scale 1 : 1


Tool#3749

REVISIONS

A1 Current

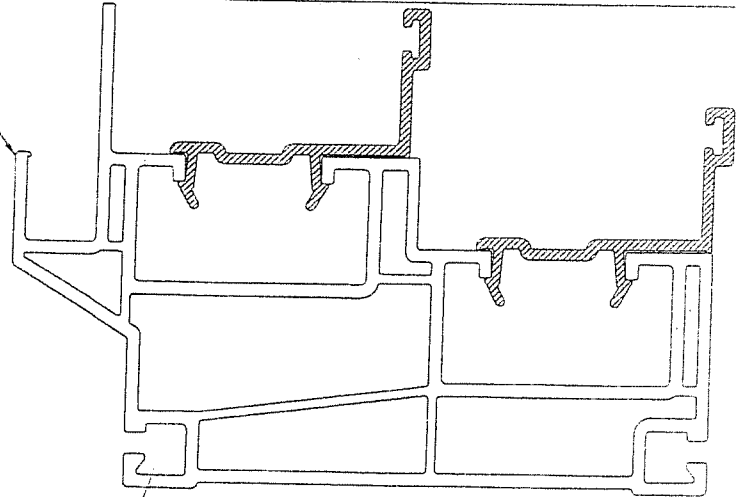

Applications Detail  
Scale 1 : 1

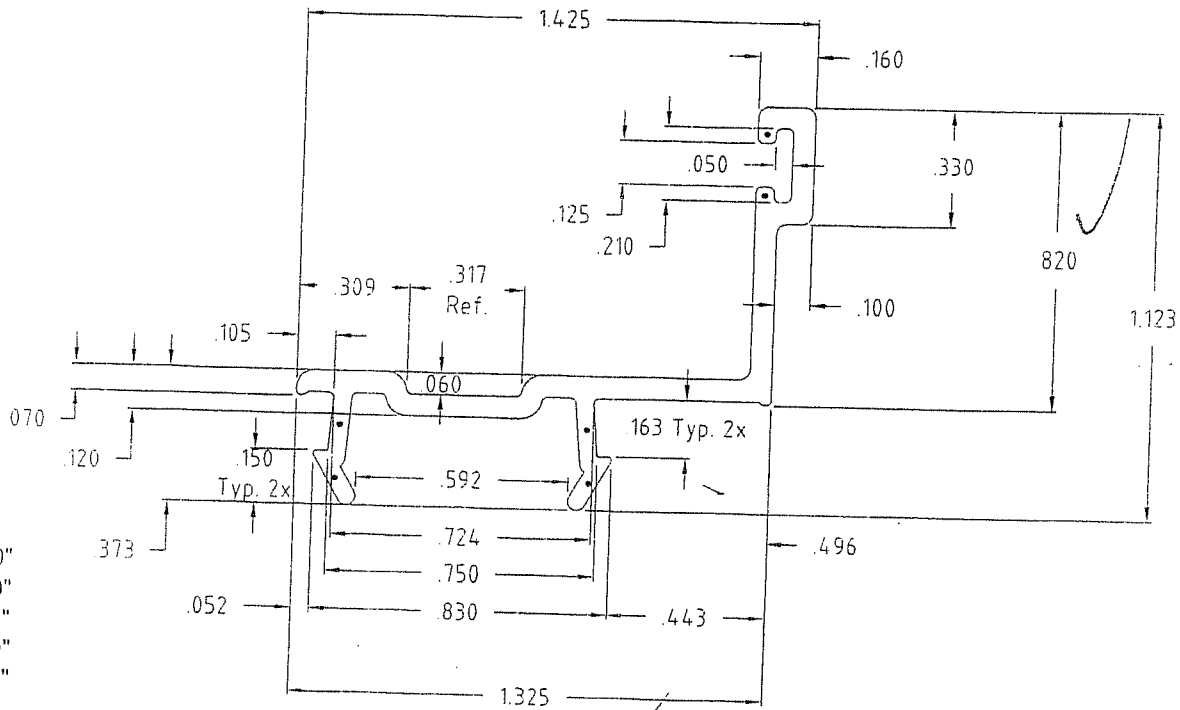

RADII:

- a = 0.010"
- b = 0.020"
- c = 0.030"
- d = 0.060"
- e = 0.080"
- f = full
- s = Sharp
- unmarked = 0.015"

WALL THICKNESS: UNLESS SPECIFIED


- NOMINAL = 0.060"
- = 0.050"

This document and the information contained is owned by and proprietary to Vision Extrusions Limited. By receipt hereof, the holder agrees not to use the information, disclose it to any third parties nor reproduce this document without the prior written consent of Vision Extrusions Limited, and agrees to return this document forthwith upon request.



<p><b>TOLERANCES</b>          X.XX ± 0.015          X.XXX ± 0.010          X.XXXX ± 0.005          DO NOT SCALE DRAWING          ALL DIMENSIONS ARE IN INCHES U.S.S.</p>		<p>CUSTOMER/DESCRIPTION:          202 Series - Sealed Pocket Cover          Part Drawing</p>		
<p>SIZE: "A"</p>	<p>COLOUR: As specified</p>	<p>MATERIAL: As specified</p>	<p>TOOL NO.: 3758</p>	<p>DATE: 03/19/2012</p>
<p>SHEET: 1 of 1</p>	<p>DRAWN BY: RJO</p>	<p>SCALE: 2 : 1</p>	<p>PART NO.: D-014</p>	<p>DWG NO.: E202X02</p>


TEST SPECIMEN COMPLIES  
WITH THESE DETAILS.  
ANY DEVIATION IS NOTED.  
REPORT NO. NCTL-110-18040-1  
TEST DATE: 12/11/15

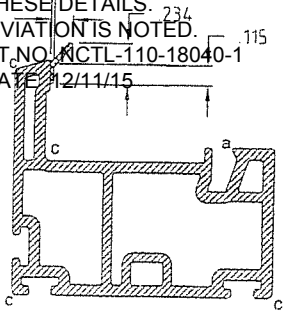

Radius & Flex Detail  
Scale 1 : 1

REVISIONS

A1 | Current

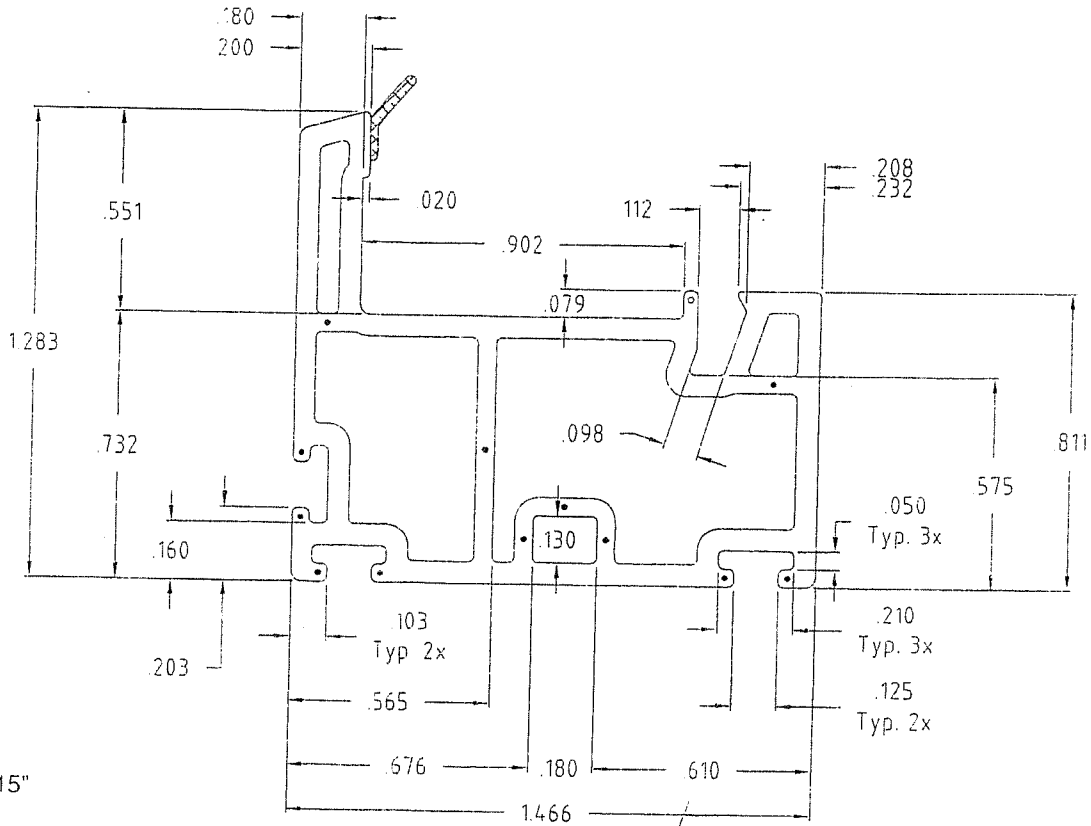

RADI:

- a = 0.010"
- b = 0.020"
- c = 0.030"
- d = 0.060"
- e = 0.080"
- f = full
- s = Sharp
- unmarked = 0.015"

FLEX AREA

WALL THICKNESS: UNLESS SPECIFIED

- NOMINAL = 0.060"
- = 0.050"
- = 0.040"

This document and the information contained is owned by and proprietary to Vision Extrusions Limited. By receipt hereof, the holder agrees not to use the information, disclose it to any third parties nor reproduce this document without the prior written consent of Vision Extrusions Limited, and agrees to return this document forthwith upon request.



<p>TOLERANCES X.XX ± 0.015 X.XXX ± 0.010 X.XXXX ± 0.005 DO NOT SCALE DRAWING ALL DIMENSIONS ARE IN INCHES U.S.</p>		<p>CUSTOMER/DESCRIPTION: <b>202 Series - Stile Sash Part Drawing</b></p>		
SIZE: "A"	COLOUR: As specified	MATERIAL: As specified	TOOL NO.: 3754	DATE: 03/19/2012
SHEET: 1 of 1	DRAWN BY: RJO	SCALE: 2 : 1	PART NO.: V-645	DWG NO.: E202S01

TEST SPECIMEN COMPLIES

WITH THESE DETAILS.


ANY DEVIATION IS NOTED.

REPORT NO. MCTL-110-18040-1


TEST DATE: 2/11/15

REVISIONS

A1 | Current

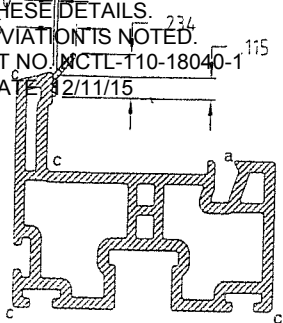

Radius & Flex Detail  
Scale 1 : 1

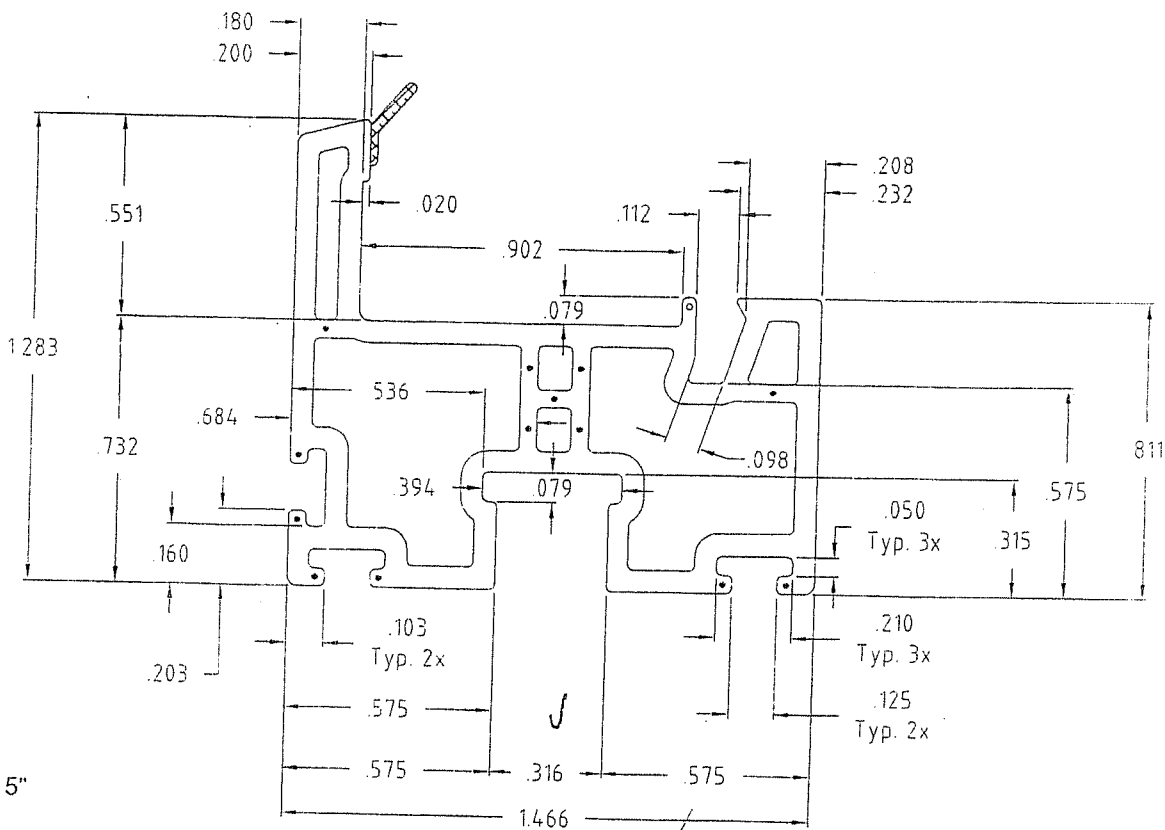

RADII:

a = 0.010"

b = 0.020"

c = 0.030"

d = 0.060"

e = 0.080"

f = full

s = Sharp

unmarked = 0.015"

FLEX AREA

WALL THICKNESS: UNLESS SPECIFIED

NOMINAL = 0.060"

• = 0.050"

◦ = 0.040"




This document and the information contained is owned by and proprietary to Vision Extrusions Limited. By receipt hereof, the holder agrees not to use the information, disclose it to any third parties nor reproduce this document without the prior written consent of Vision Extrusions Limited, and agrees to return this document forthwith upon request.

<p><b>TOLERANCES</b>                  X.XX ± 0.015                  X.XXX ± 0.010                  X.XXXX ± 0.005                  DO NOT SCALE DRAWING                  ALL DIMENSIONS ARE IN INCHES U.S.S.</p>		<p>CUSTOMER/DESCRIPTION:                  202 Series - Sash Rail                  Part Drawing</p>		
SIZE: "A"	COLOUR: As specified	MATERIAL: As specified	TOOL NO.: 3755	DATE: 03/19/2012
SHEET: 1 of 1	DRAWN BY: RJO	SCALE: 2 : 1	PART NO.: V-224	DWG NO.: E202S02




TEST SPECIMEN COMPLIES  
 WITH THESE DETAILS.  
 ANY DEVIATION IS NOTED.  
 REPORT NO. NCTL-110-18040-1  
 TEST DATE 12/11/15

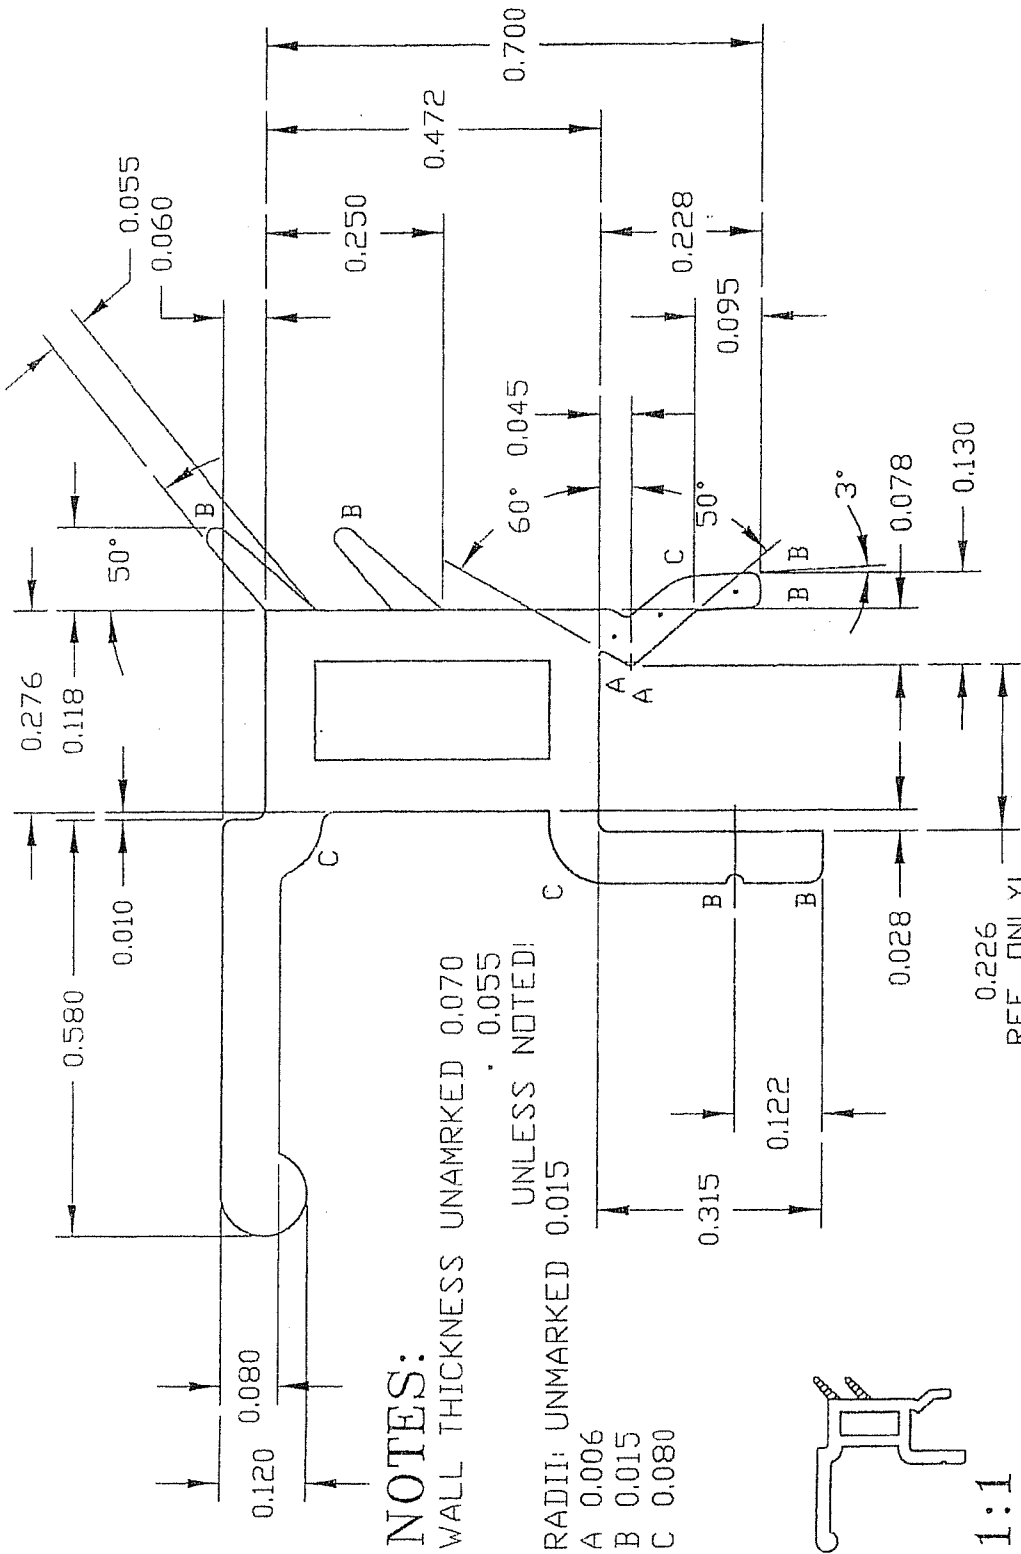

**NOTES:**  
 WALL THICKNESS UNAMRKED 0.070  
 UNLESS NOTED!  
 RADI: UNAMRKED 0.015

- A 0.006
- B 0.015
- C 0.080

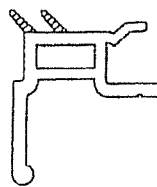

1:1



**DOMINION  
 PLASTICS  
 INC.**

CUSTOMER:

**DOMINION**

PART NAME:

**7/8" PULL RAIL STOP**



MATERIAL: PVC	FILE No.	DIE No.
SCALE: 4:1		D584
DWN BY: CDF	DATE	PRG. No.
CHKD BY:	25-JULY-97	D909

TEST SPECIMEN COMPLIES WITH THESE DETAILS.

ANY DEVIATION IS NOTED.

REPORT NO. NCTL-110-18040-1

TEST DATE 12/11/15

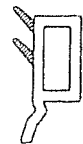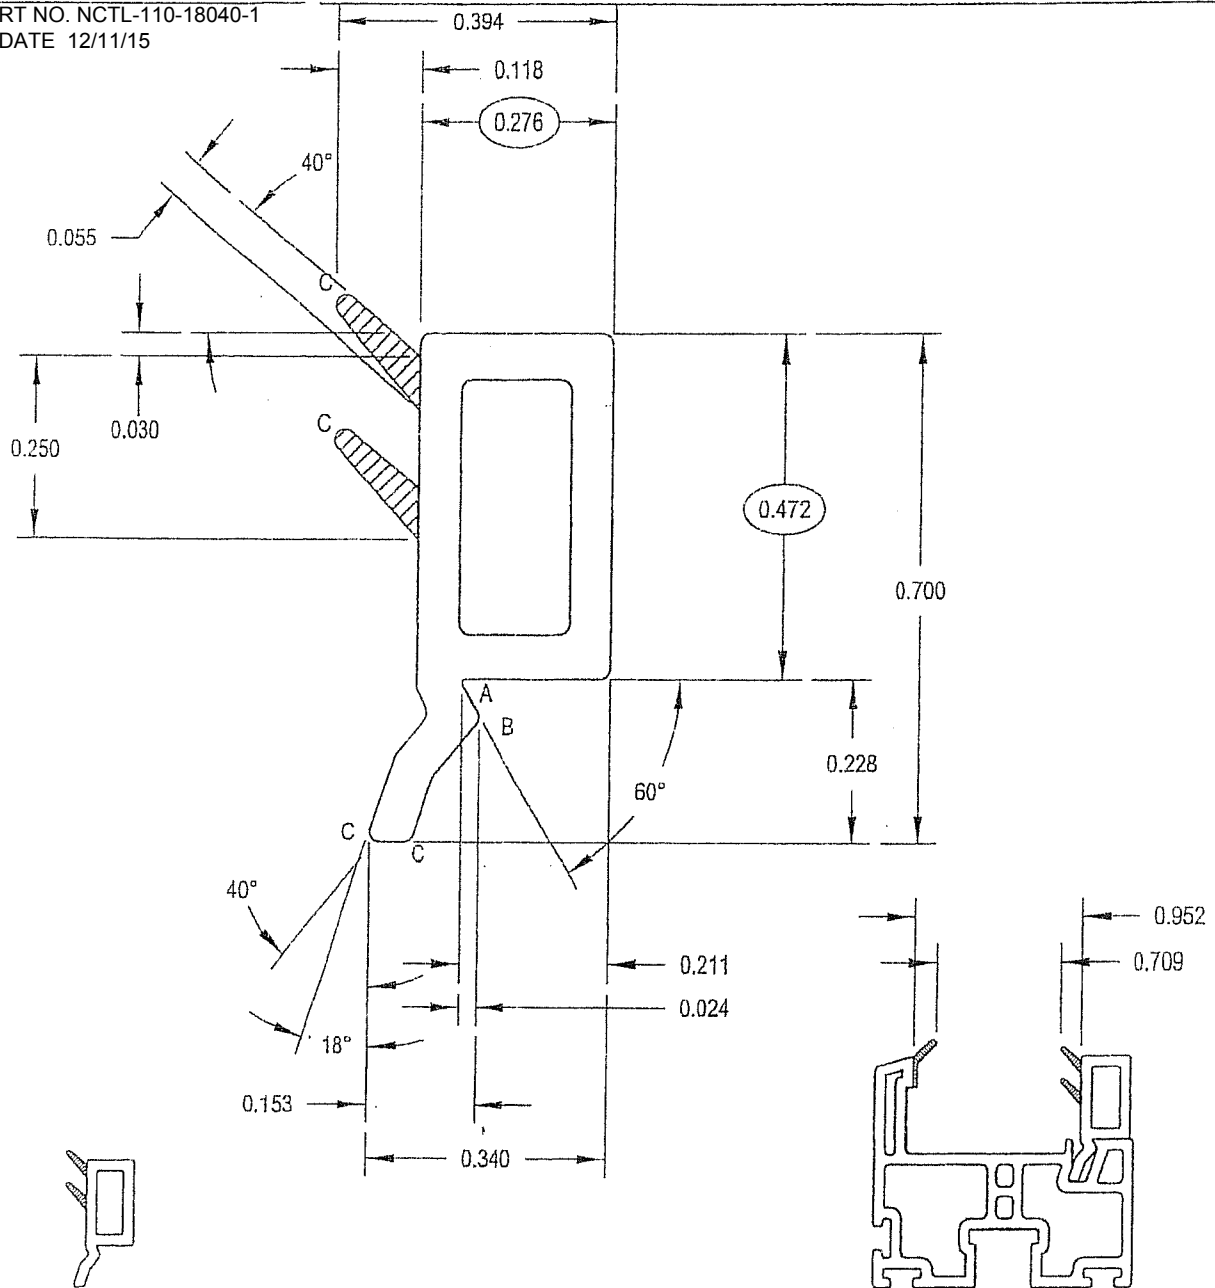

1:1

ALL DIMENSIONS TOLERANCED TO +/- 0.020" UNLESS SPECIFIED

REVISIONS

- 1) REDUCE WALL THICKNESS 14/FEB/01
- 2) MOVE FLEX AND CHANGE HOOK

NOTES:

WALL THICKNESS:

EXTERIOR: 0.060

INTERIOR: —

TOLERANCES +/- 0.006"

RADII:

A 0.006

B 0.010

C 0.015

D —

UNMARKED: 0.015

E —

F FULL

G —

H —

I —

J —

K —

S SHARP

SYMBOLS:

— = CAPSTOCK

⊕ = THEORETICAL SHARP

○ = HOLD DIMENSION

+/- 0.005



**Dominion  
Plastics  
Inc.**

CUSTOMER:

**DOMINION**

DESCRIPTION:

**7/8" GLASS STOP**

This document is owned by and the information contained in it is proprietary to **DOMINION PLASTICS INC.** by receipt hereof the holder agrees not to use the information, disclose it to any third party nor reproduce this document without the prior written consent of **DOMINION PLASTICS INC.** and agrees to return this document forthwith upon request.

DATE:

**14-FEB-01**

SCALE:

**4:1**

DRAWN BY:

**CDF**

MATERIAL:

**PVC**

DWG. NO.

PROJECT. NO.

DIE NO.

**D585**


PROG. NO.

**D910**

REV. NO.

**2**

TEST SPECIMEN COMPLIES  
 WITH THESE DETAILS.  
 ANY DEVIATION IS NOTED.  
 REPORT NO. NCTL-110-18040-1  
 TEST DATE 12/11/15

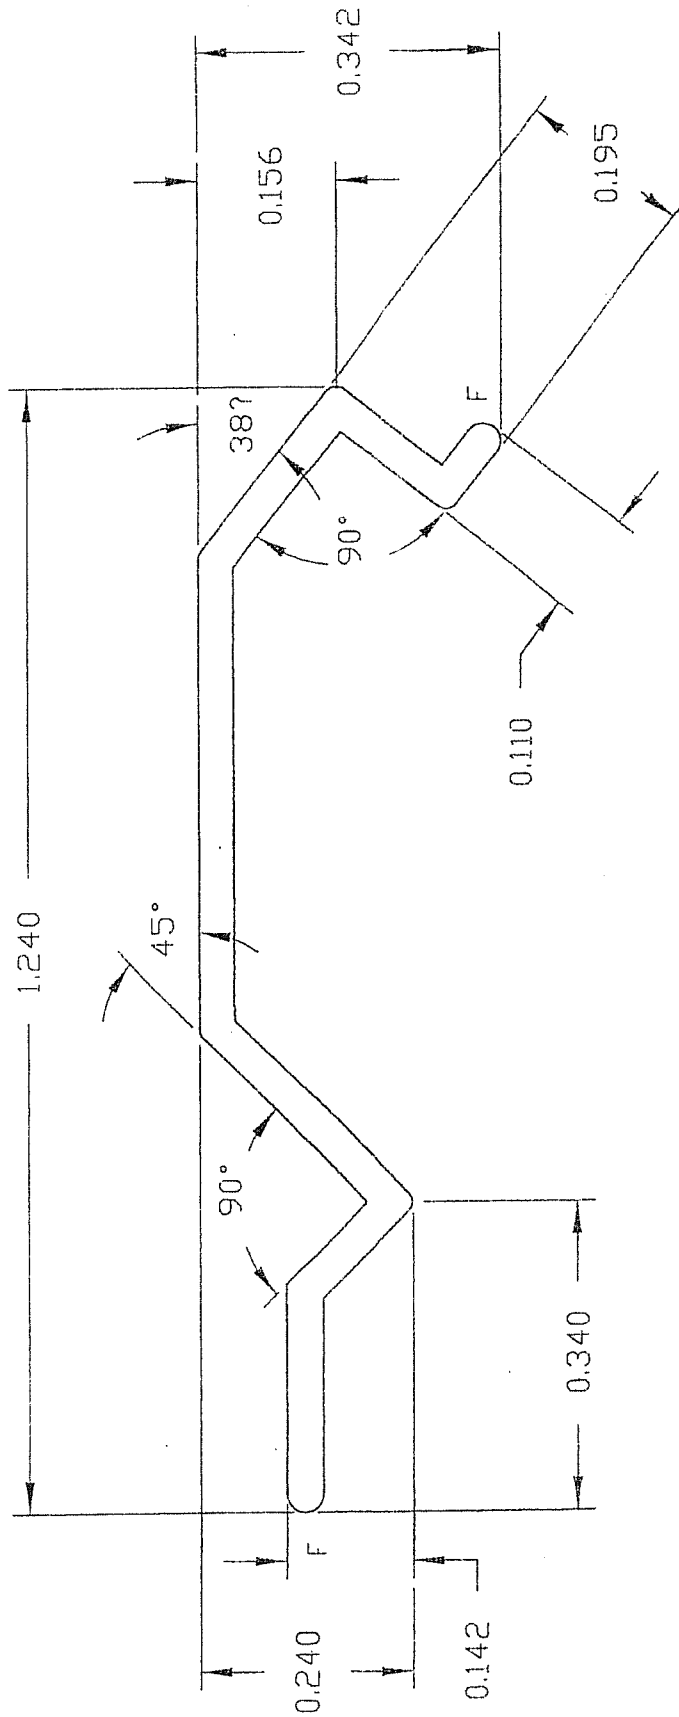


NOTES:



WALL THICKNESS: 0.040  
 RADII: UNMARKED 0.015  
 F FULL




1:1

 <b>DOMINION          PLASTICS          LTD</b>	CUSTOMER:	DOMINION	
	PART NAME:	BALANCE COVER	
	MATERIAL: PVC	FILE No.	DIE No:
	SCALE: 5:1		D514
	DWN BY: CDI	DATE:	PRG No.
	CHKD BY:	16-FEB-93	D1550

TEST SPECIMEN COMPLIES  
 WITH THESE DETAILS.  
 ANY DEVIATION IS NOTED.  
 REPORT NO. NCTL-110-18040-1  
 TEST DATE 12/11/15

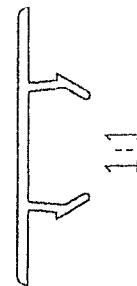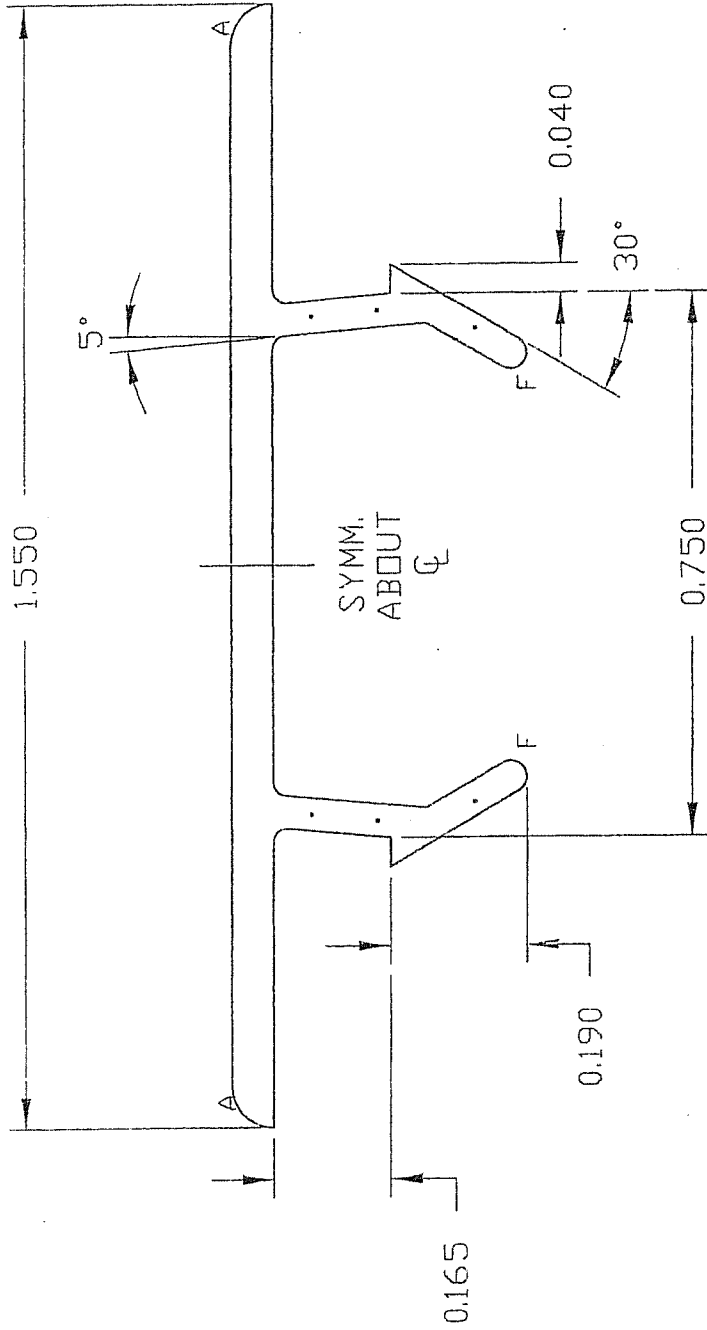


WALL THICKNESS: 0.060  
 0.045  
 RADI: UNMARKED 0.015  
 A 0.060  
 F FULL

 <b>DOMINION          PLASTICS          LTD</b>	CUSTOMER: <b>DOMINION</b>		PART NAME: <b>FLAT POCKET COVER</b>	
	MATERIAL: PVC		FILE No.	
SCALE: 4:1		DIE No: D575		
DWN BY: CDI		DATE: 29-JUNE-92		
CHKD BY.		PROG No. D1061		

TEST SPECIMEN COMPLIES WITH THESE DETAILS. ANY DEVIATION IS NOTED. REPORT NO. NCTL-110-18040-1 TEST DATE 12/11/15

SS 0.088  
2.2

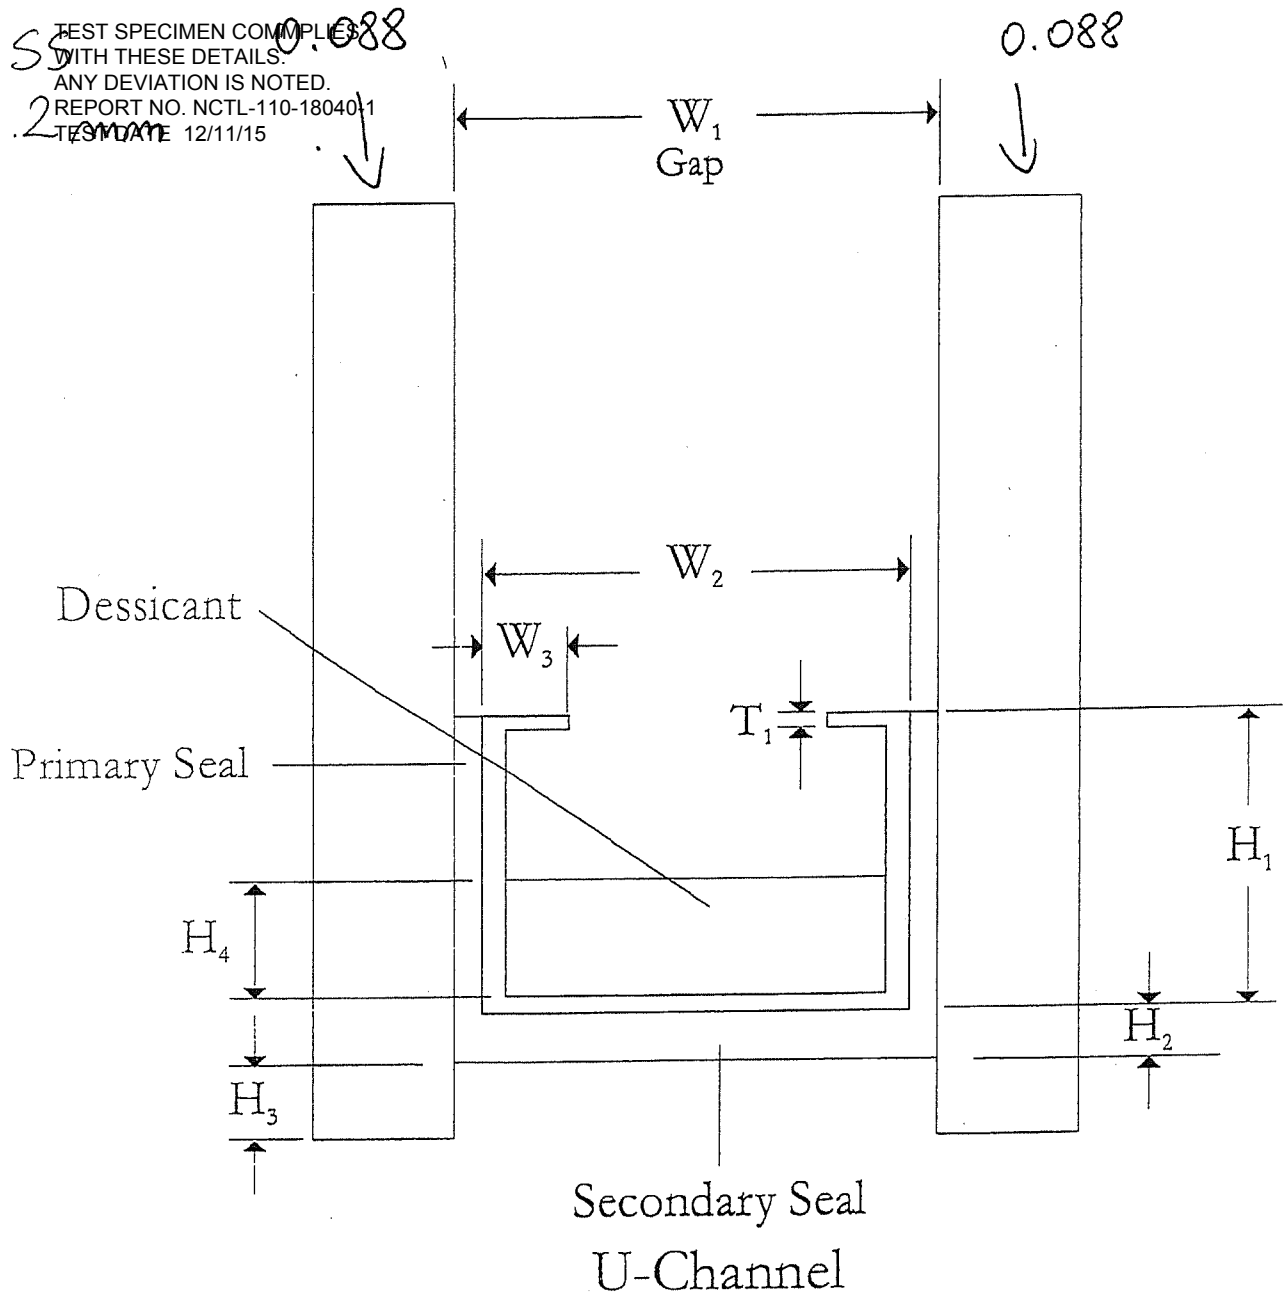


Spacer Dimensions - Fill dimensions where applicable - Please fill out a spacer sheet for each spacer used whether spacer type or size.

Gap	Primary Seal	Secondary Seal	Material	Fill
<input type="checkbox"/> W <sub>1</sub> <u>.699"</u>	<input checked="" type="checkbox"/> Butyl	<input type="checkbox"/> Butyl	<input type="checkbox"/> Aluminum	<input checked="" type="checkbox"/> Desiccant
<input checked="" type="checkbox"/> W <sub>2</sub> <u>.657"</u>	<input type="checkbox"/> PIB	<input type="checkbox"/> PIB	<input type="checkbox"/> Steel - Mild	<input type="checkbox"/> Air
<input type="checkbox"/> W <sub>3</sub> <u>.128"</u>	<input type="checkbox"/> Polysulphide	<input type="checkbox"/> Polysulphide	<input type="checkbox"/> Steel - Stainless	<input type="checkbox"/> Other _____
<input type="checkbox"/> W <sub>4</sub> _____	<input type="checkbox"/> Silicone	<input type="checkbox"/> Silicone	<input checked="" type="checkbox"/> Steel - Galvanized	
<input type="checkbox"/> H <sub>1</sub> <u>.300"</u>	<input type="checkbox"/> Urethane	<input type="checkbox"/> Urethane	<input type="checkbox"/> Vinyl	
<input type="checkbox"/> H <sub>2</sub> <u>.050"</u>	<input type="checkbox"/> None	<input type="checkbox"/> None	<input type="checkbox"/> Foam _____	
<input type="checkbox"/> H <sub>3</sub> <u>.062"</u>	<input type="checkbox"/> Other _____	<input type="checkbox"/> Other _____	<input type="checkbox"/> Other _____	
<input type="checkbox"/> H <sub>4</sub> <u>.065"</u>				
<input type="checkbox"/> H <sub>5</sub> _____				
<input type="checkbox"/> T <sub>1</sub> <u>.011"</u>				

7/8"

with SS GLASS  
2.2 mm = 0.088 inch

TEST SPECIMEN COMPLIES WITH THESE DETAILS.  
 ANY DEVIATION IS NOTED.  
 REPORT NO. NCTL-110-18040-1  
 TEST DATE 12/11/15

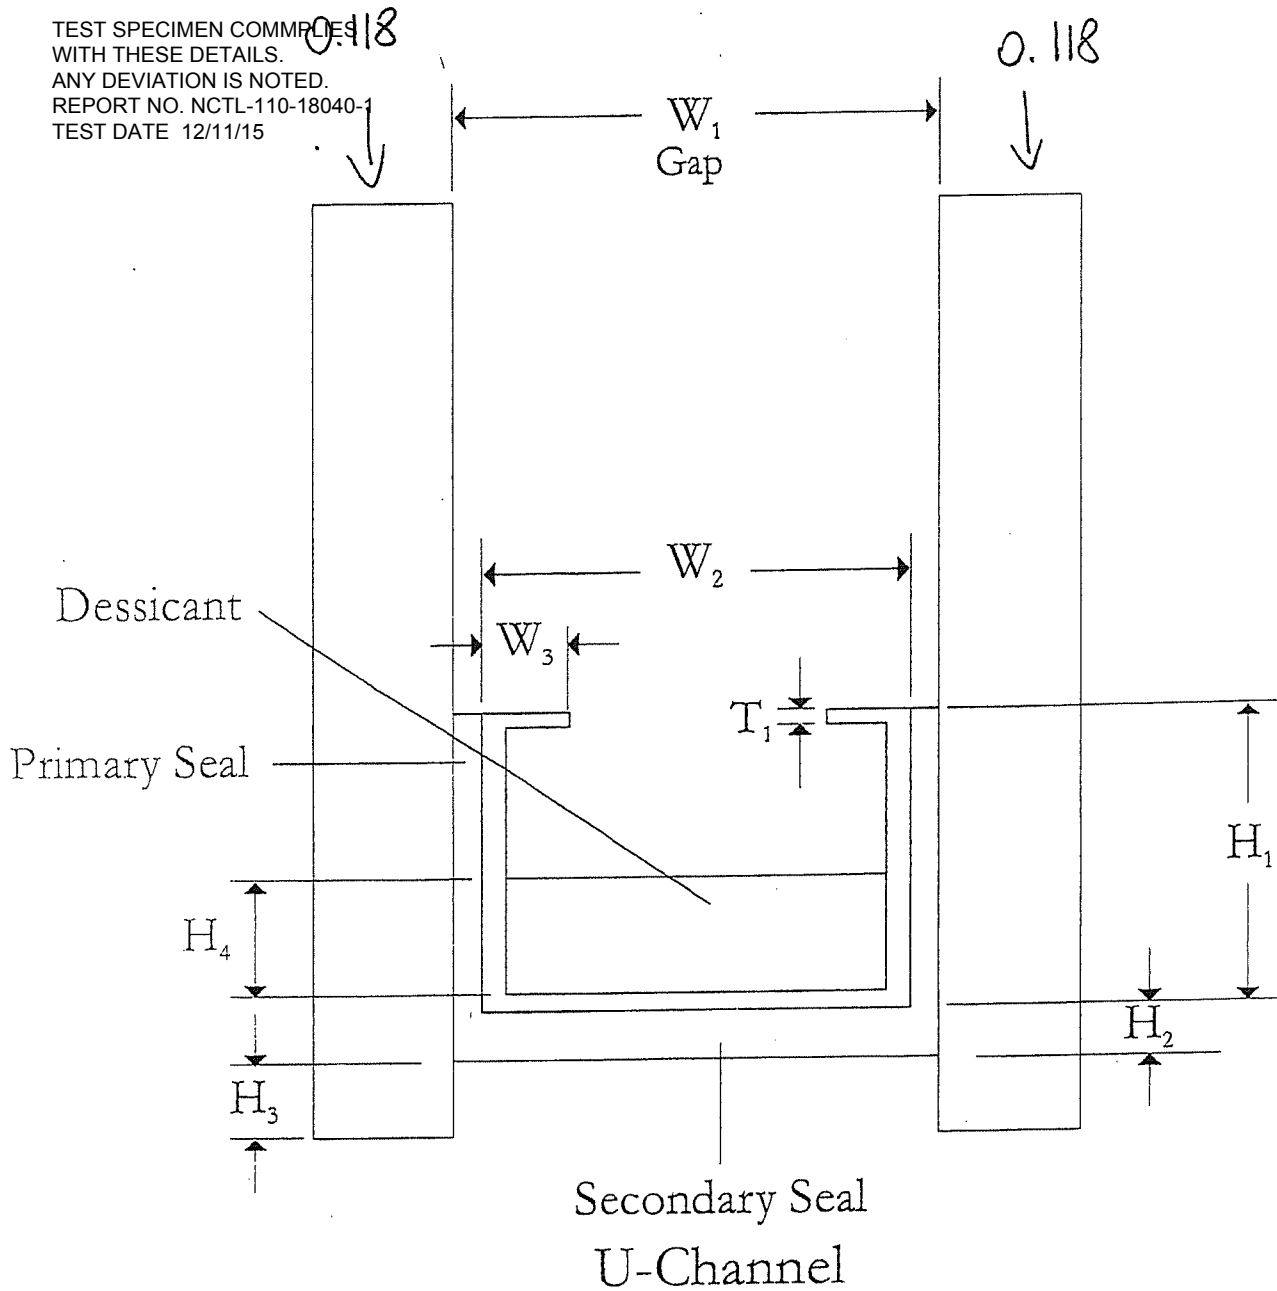


Spacer Dimensions - Fill dimensions where applicable - Please fill out a spacer sheet for each spacer used whether spacer type or size.

Gap	Primary Seal	Secondary Seal	Material	Fill
<input type="checkbox"/> W <sub>1</sub> <u>.639</u> "	<input checked="" type="checkbox"/> Butyl	<input type="checkbox"/> Butyl	<input type="checkbox"/> Aluminum	<input checked="" type="checkbox"/> Dessicant
<input type="checkbox"/> W <sub>2</sub> <u>.594</u> "	<input type="checkbox"/> PIB	<input type="checkbox"/> PIB	<input type="checkbox"/> Steel - Mild	<input type="checkbox"/> Air
<input type="checkbox"/> W <sub>3</sub> <u>.128</u> "	<input type="checkbox"/> Polysulphide	<input type="checkbox"/> Polysulphide	<input type="checkbox"/> Steel - Stainless	<input type="checkbox"/> Other _____
<input type="checkbox"/> W <sub>4</sub> _____ "	<input type="checkbox"/> Silicone	<input type="checkbox"/> Silicone	<input checked="" type="checkbox"/> Steel - Galvanized	
<input type="checkbox"/> H <sub>1</sub> <u>.300</u> "	<input type="checkbox"/> Urethane	<input type="checkbox"/> Urethane	<input type="checkbox"/> Vinyl	
<input type="checkbox"/> H <sub>2</sub> <u>.050</u> "	<input type="checkbox"/> None	<input type="checkbox"/> None	<input type="checkbox"/> Foam _____	
<input type="checkbox"/> H <sub>3</sub> <u>.062</u> "	<input type="checkbox"/> Other _____	<input type="checkbox"/> Other _____	<input type="checkbox"/> Other _____	
<input type="checkbox"/> H <sub>4</sub> <u>.065</u> "				
<input type="checkbox"/> H <sub>5</sub> _____ "				
<input type="checkbox"/> T <sub>1</sub> <u>.011</u> "				

7/8" with DS GLASS  
 3mm = 0.118 inch

TEST SPECIMEN COMPLIES WITH THESE DETAILS. ANY DEVIATION IS NOTED.  
 REPORT NO. NCTL-110-18040-1  
 TEST DATE 12/11/15

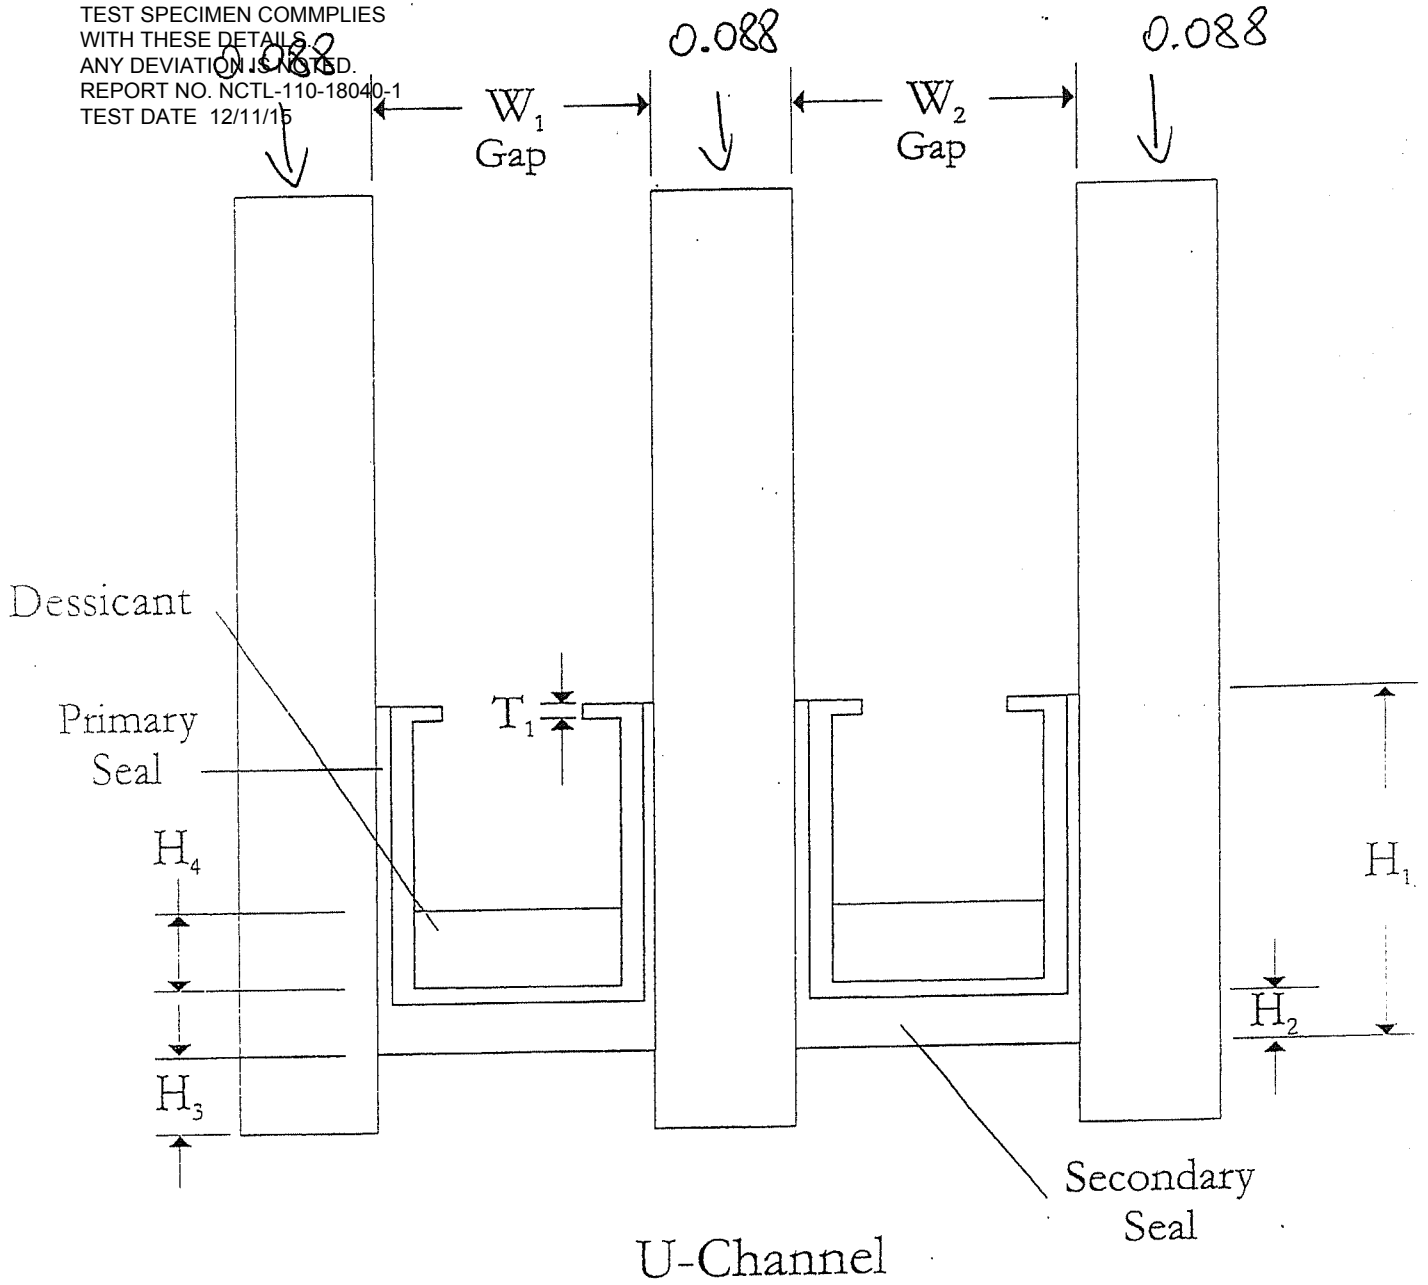

Spacer Dimensions - Fill dimensions where applicable - Please fill out a spacer sheet for each spacer used whether spacer type or size.

	Gap	Primary Seal	Secondary Seal	Material	Fill
<input type="checkbox"/>	$W_1$ .306"	<input checked="" type="checkbox"/> Butyl	<input type="checkbox"/> Butyl	<input type="checkbox"/> Aluminum	<input checked="" type="checkbox"/> Dessicant
<input type="checkbox"/>	$W_2$ .266"	<input type="checkbox"/> PIB	<input type="checkbox"/> PIB	<input type="checkbox"/> Steel - Mild	<input type="checkbox"/> Air
<input type="checkbox"/>	$W_3$ .078"	<input type="checkbox"/> Polysulphide	<input type="checkbox"/> Polysulphide	<input type="checkbox"/> Steel - Stainless	<input type="checkbox"/> Other _____
<input type="checkbox"/>	$W_4$ _____"	<input type="checkbox"/> Silicone	<input type="checkbox"/> Silicone	<input checked="" type="checkbox"/> Steel - Galvanized	
<input type="checkbox"/>	$H_1$ .300"	<input type="checkbox"/> Urethane	<input type="checkbox"/> Urethane	<input type="checkbox"/> Vinyl	
<input type="checkbox"/>	$H_2$ .050"	<input type="checkbox"/> None	<input type="checkbox"/> None	<input type="checkbox"/> Foam _____	
<input type="checkbox"/>	$H_3$ .062"	<input type="checkbox"/> Other _____	<input type="checkbox"/> Other _____	<input type="checkbox"/> Other _____	
<input type="checkbox"/>	$H_4$ .065"				
<input type="checkbox"/>	$H_5$ _____"				
<input type="checkbox"/>	$T_1$ .011"				

7/8" TRIPLE with 2.2 mm GLASS  
 3 x 0.088 inch